


A.E. SETTING PLAN

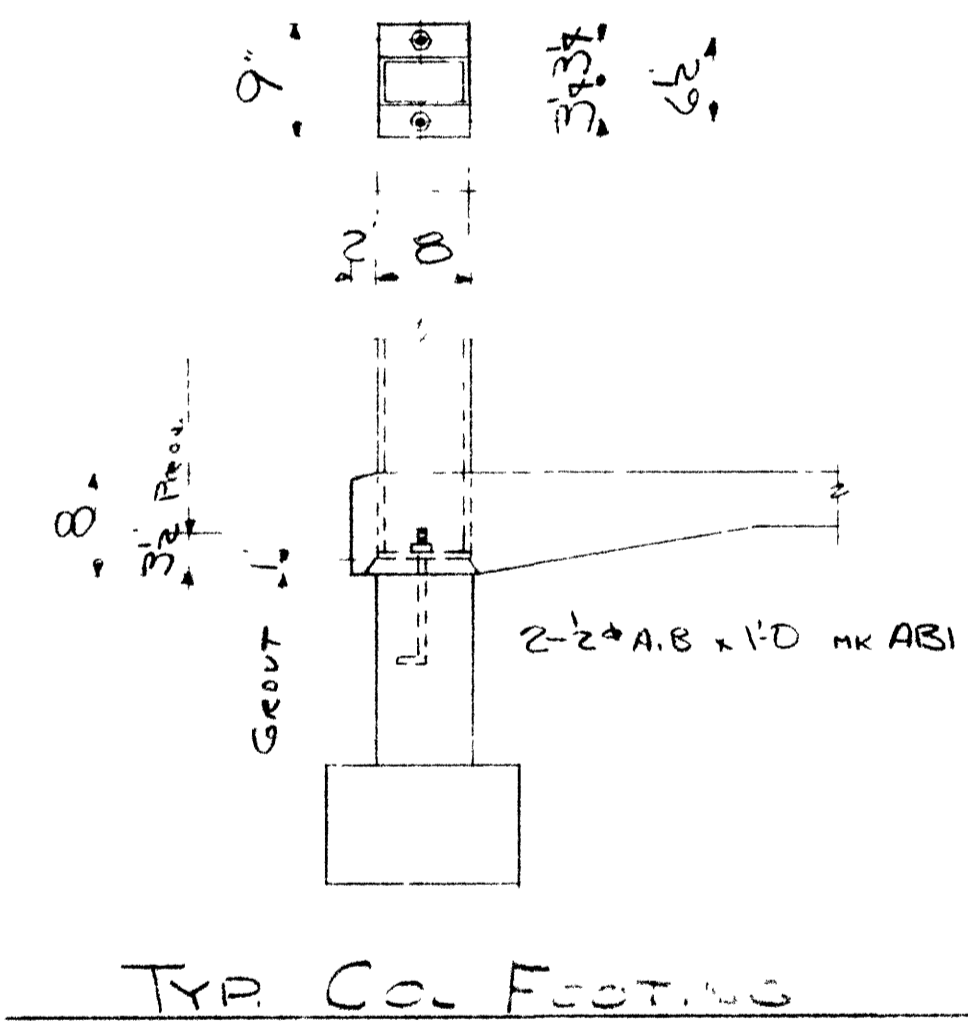

TYP. COL. FOOTING

THIS DRAWING IS:
 APPROVED
 APPROVED AS NOTED
 RETURNED FOR CORRECTION
 RESUBMIT

APPROVAL IS FOR COMPLIANCE WITH CONTRACT DOCUMENTS ONLY. CONTRACTOR IS RESPONSIBLE FOR FABRICATION AND COORDINATION OF THE WORK.
 BY BMF DATE OCT 18 1975
 BOWEN & FEINBERG ASSOCIATES
 CONSULTING ENGINEERS

FOR APPROVAL ONLY

WE ASSUME NO RESPONSIBILITY FOR ERRORS WHEN MATERIAL IS FABRICATED IN ACCORDANCE WITH APPROVED DRAWING.
 BACKCHARGES WILL NOT BE ACCEPTED UNLESS OUR CONSENT IS GIVEN IN ADVANCE IN WRITING.

ARCHITECT PLEASE VERIFY PLAN DIMENSIONS

FOR APPROVAL ONLY

TRACO STEEL INC. SANDY SPRINGS, S.C. 29677			
PROJECT: <u>ANDREWS KINDERGARDEN</u>	DATE:		
LOCATION: <u>ANDREWS, N.C.</u>	REVISED:		
DWG. COVERS: <u>A.E. SETTING PLAN</u>	APPROVAL: <u>10-1-75</u>		
ARCHT. OR ENGR.: <u>ERIC TOWNSON</u>	FIELD USE:		
CONTRACTOR: <u>BUNCOMBE CONSTR.</u>	SHOP:		
SHOP NOTES:	SHOP PAINT	HOLES U. N.	
DRAWN BY <u>W.S.T.</u>	JOB NO.	DRWG. NO.	
CHK. BY		E-1	