
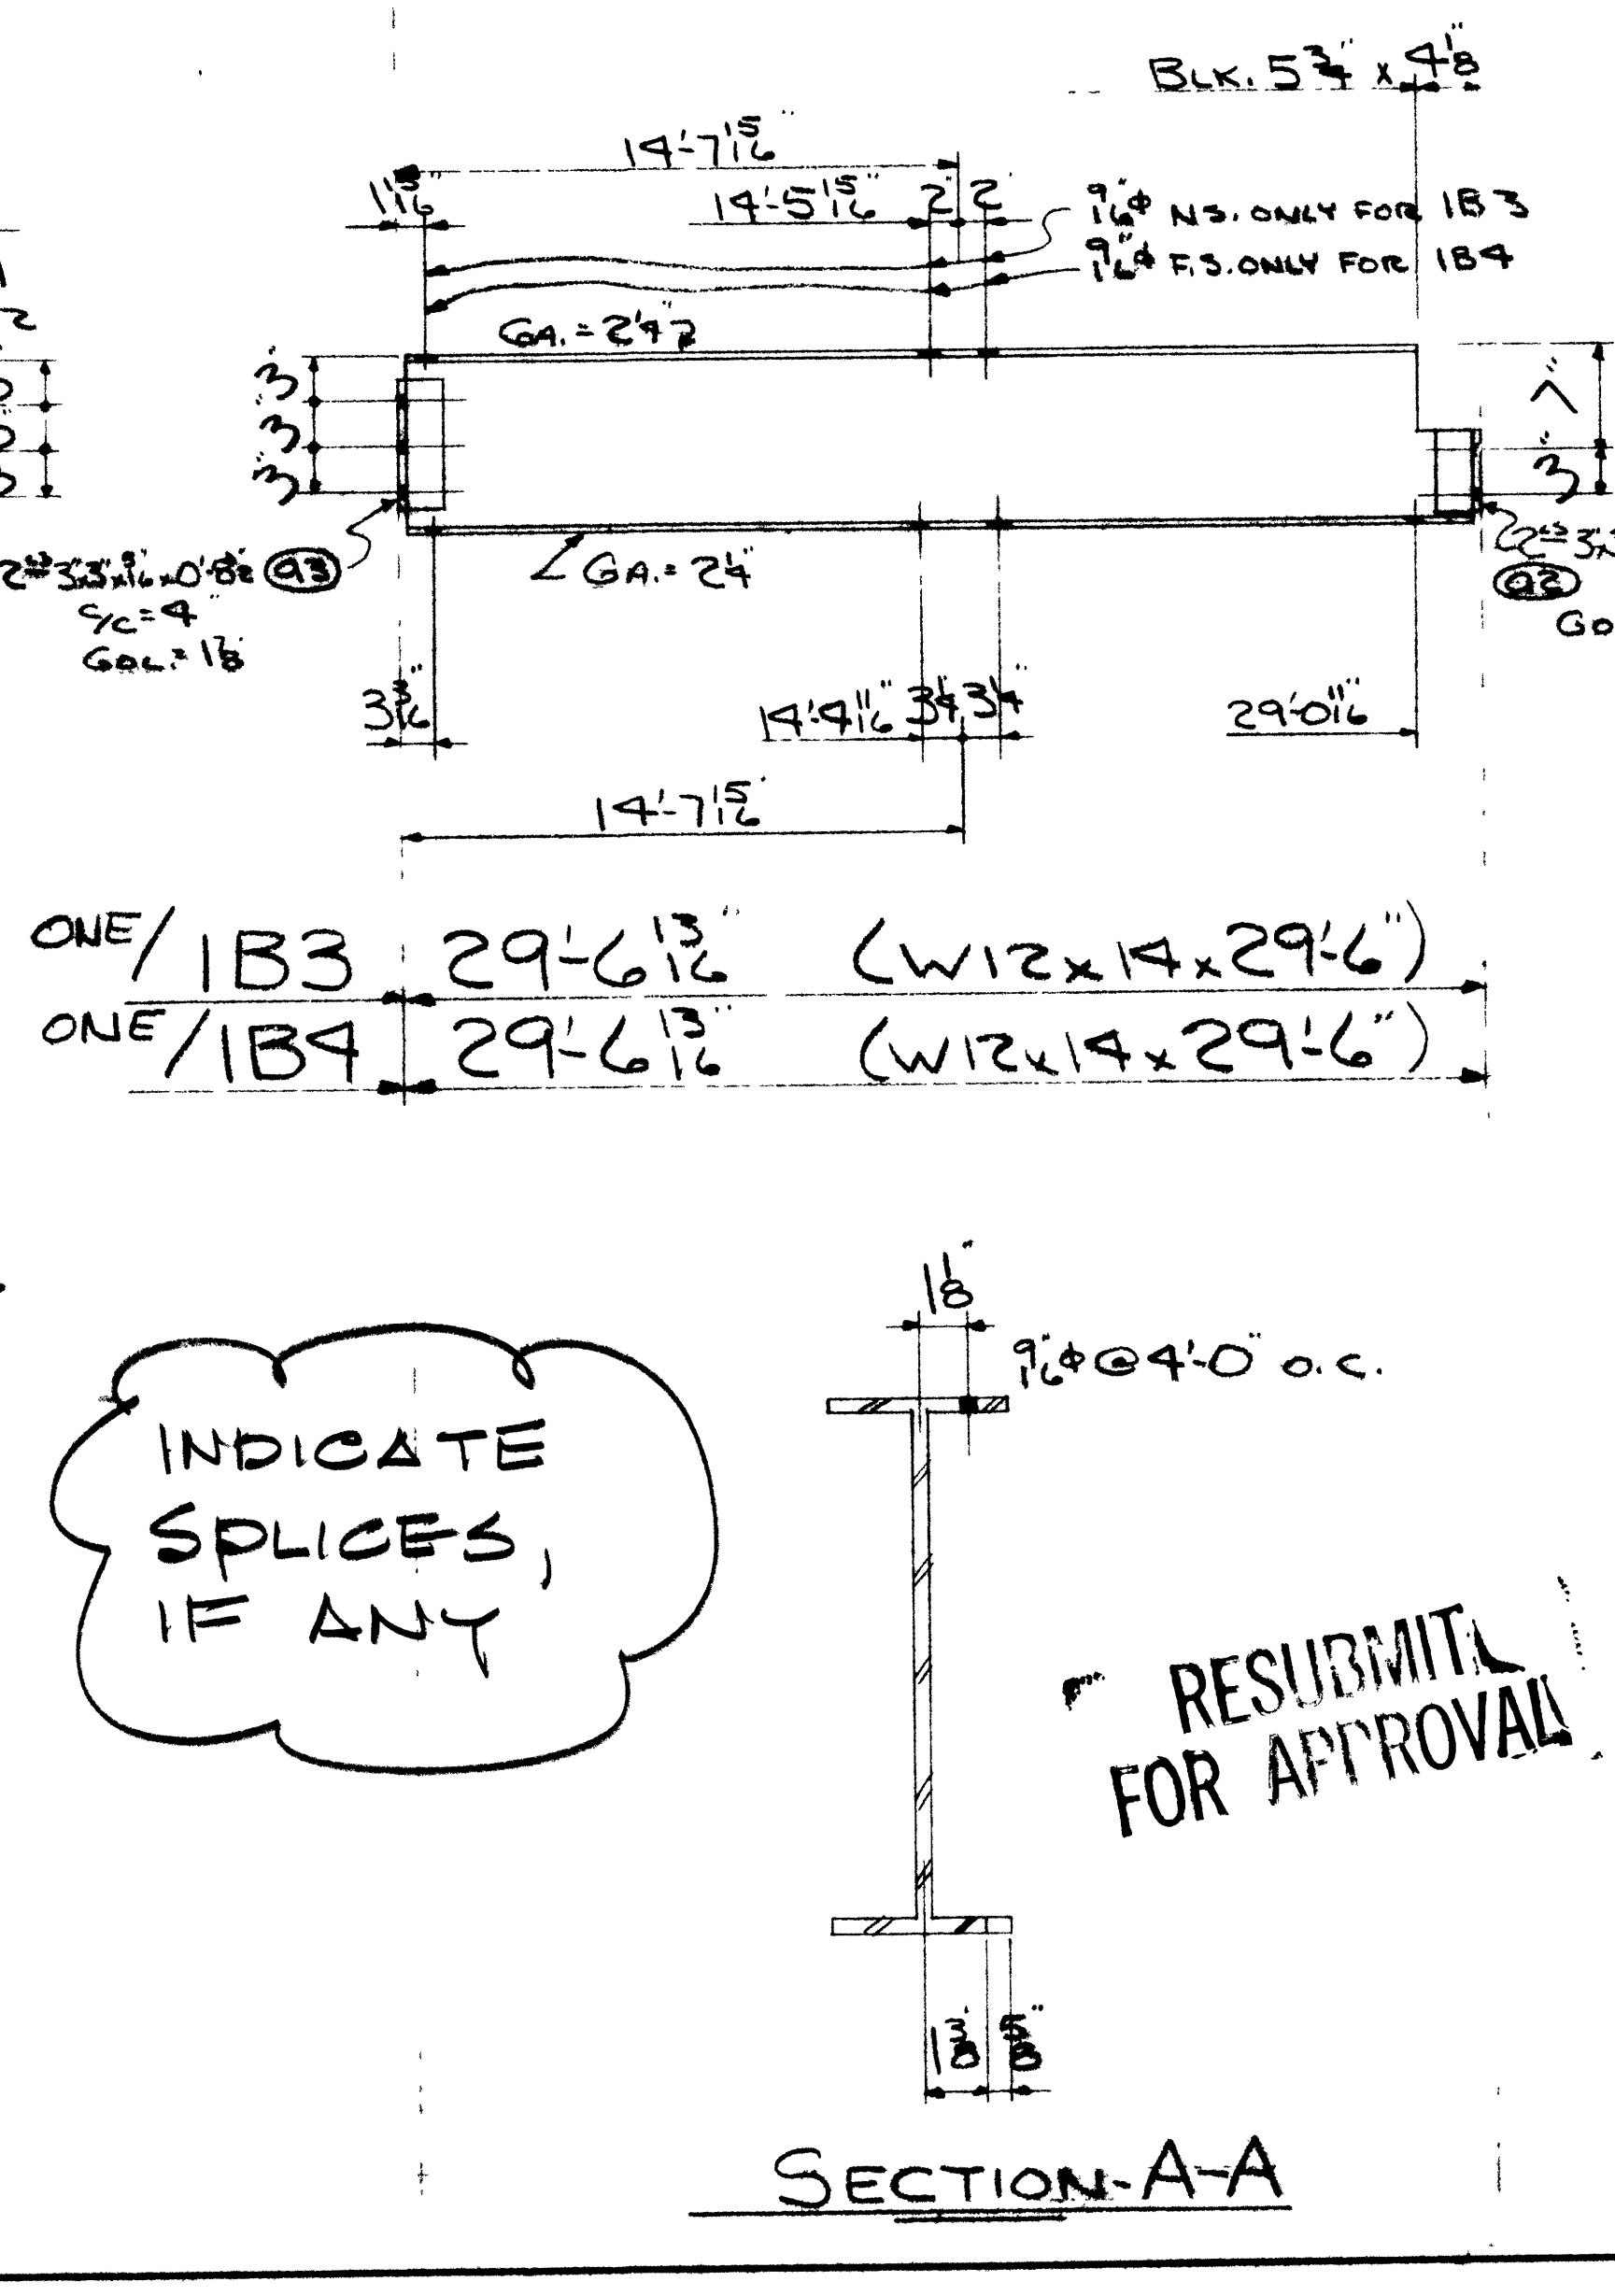
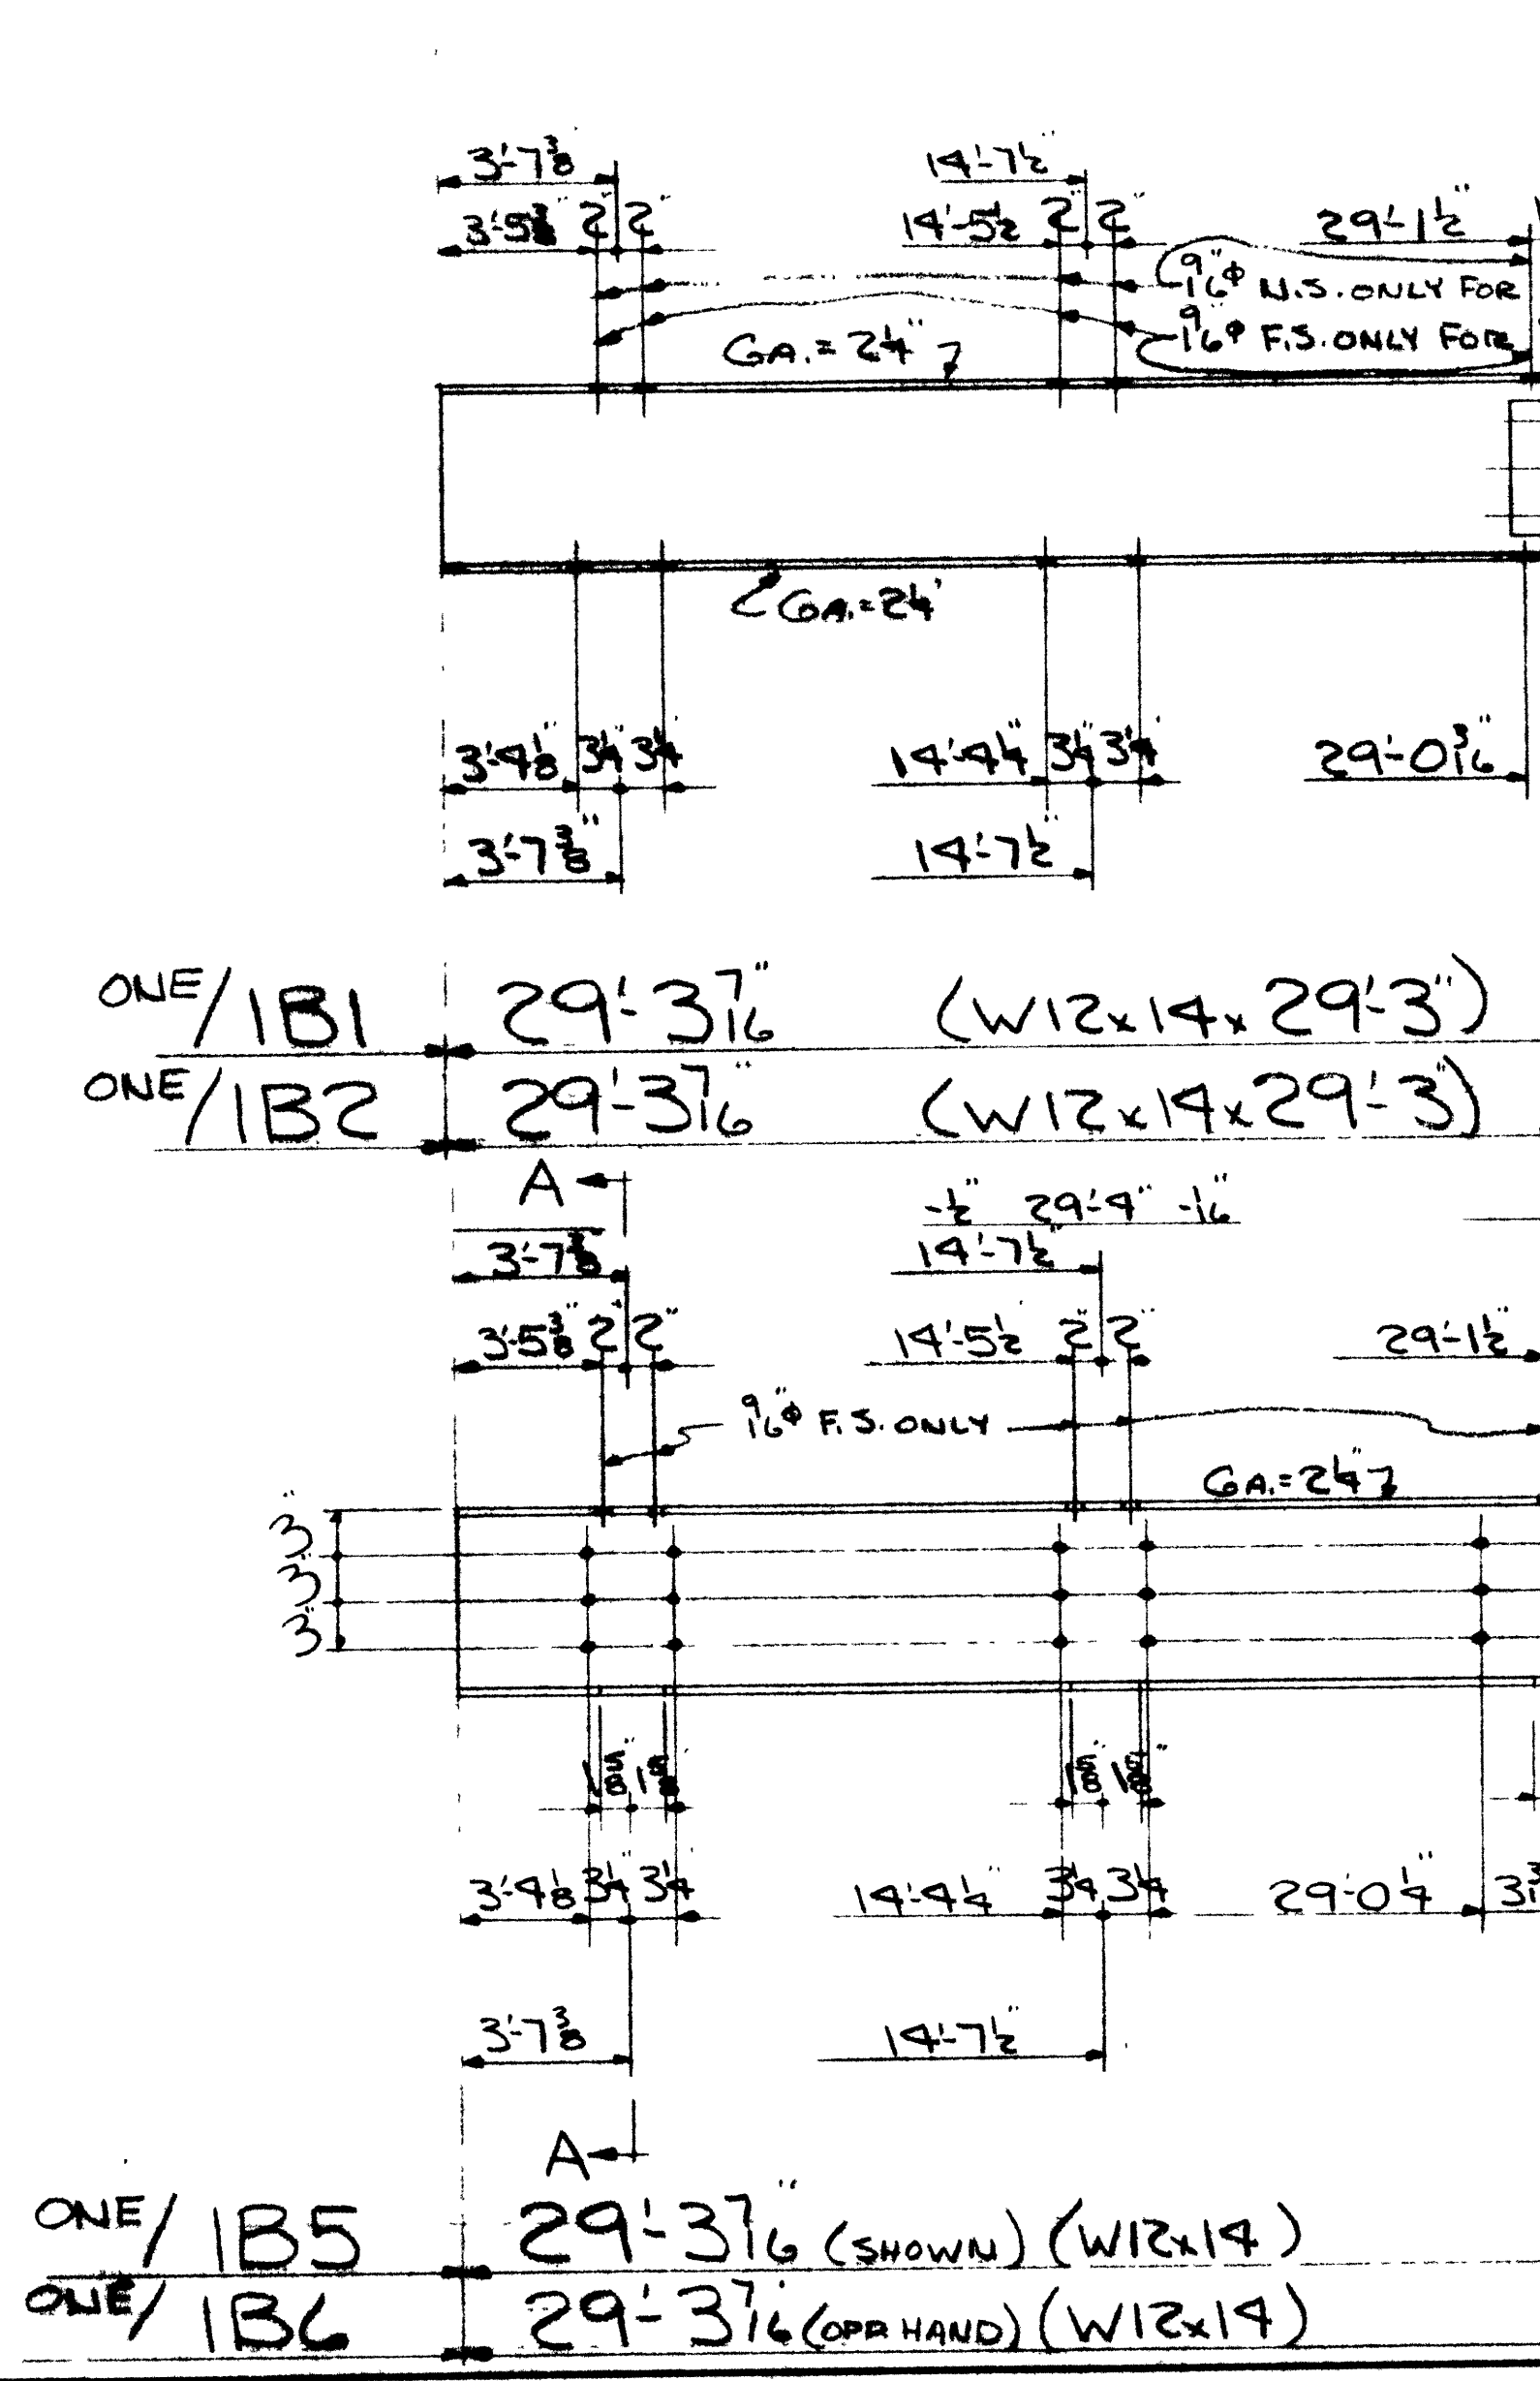
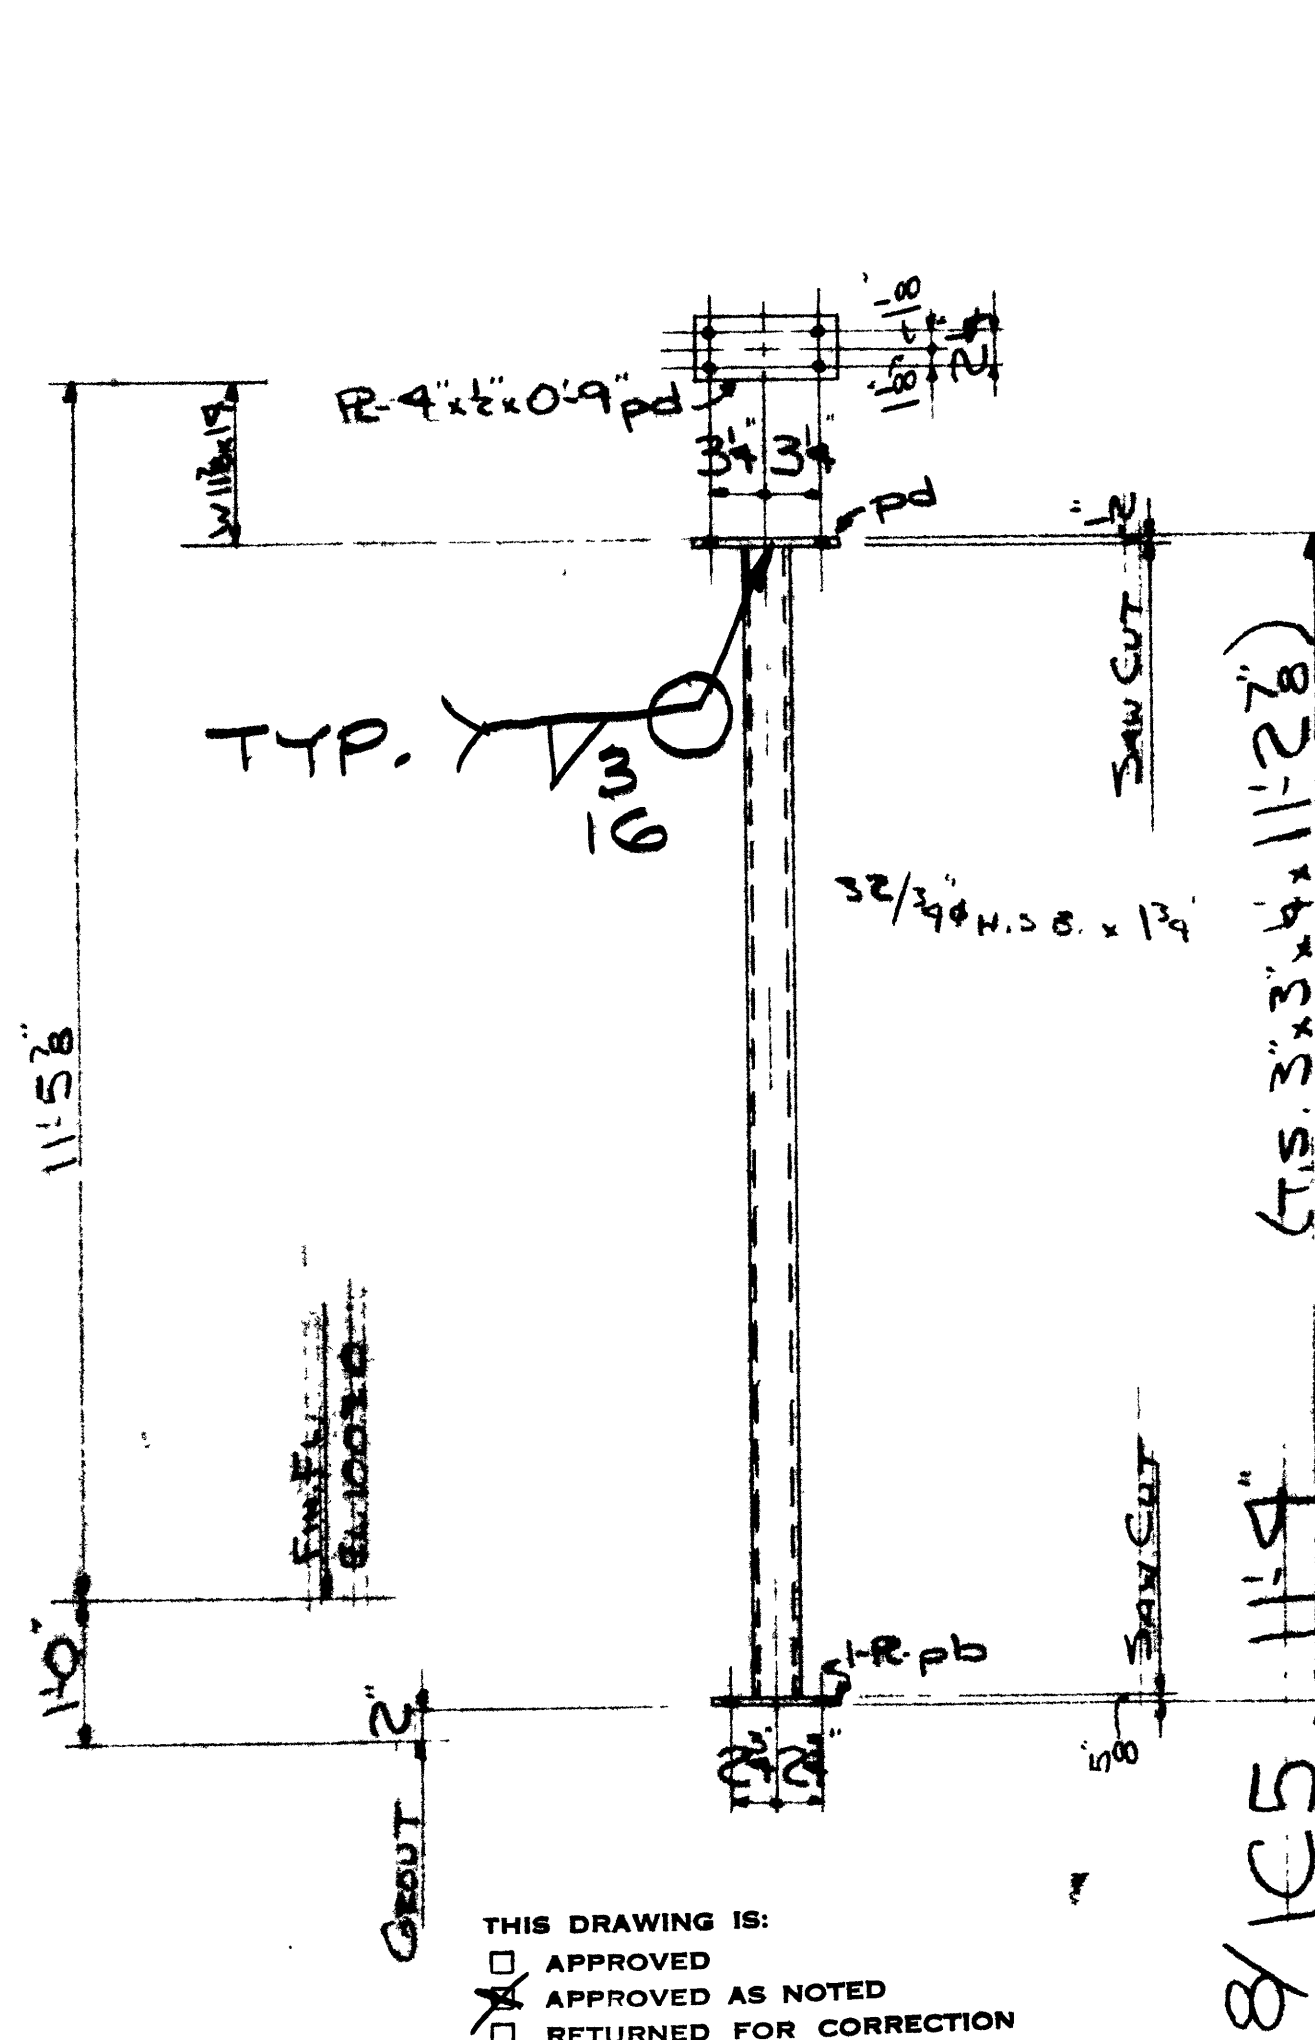
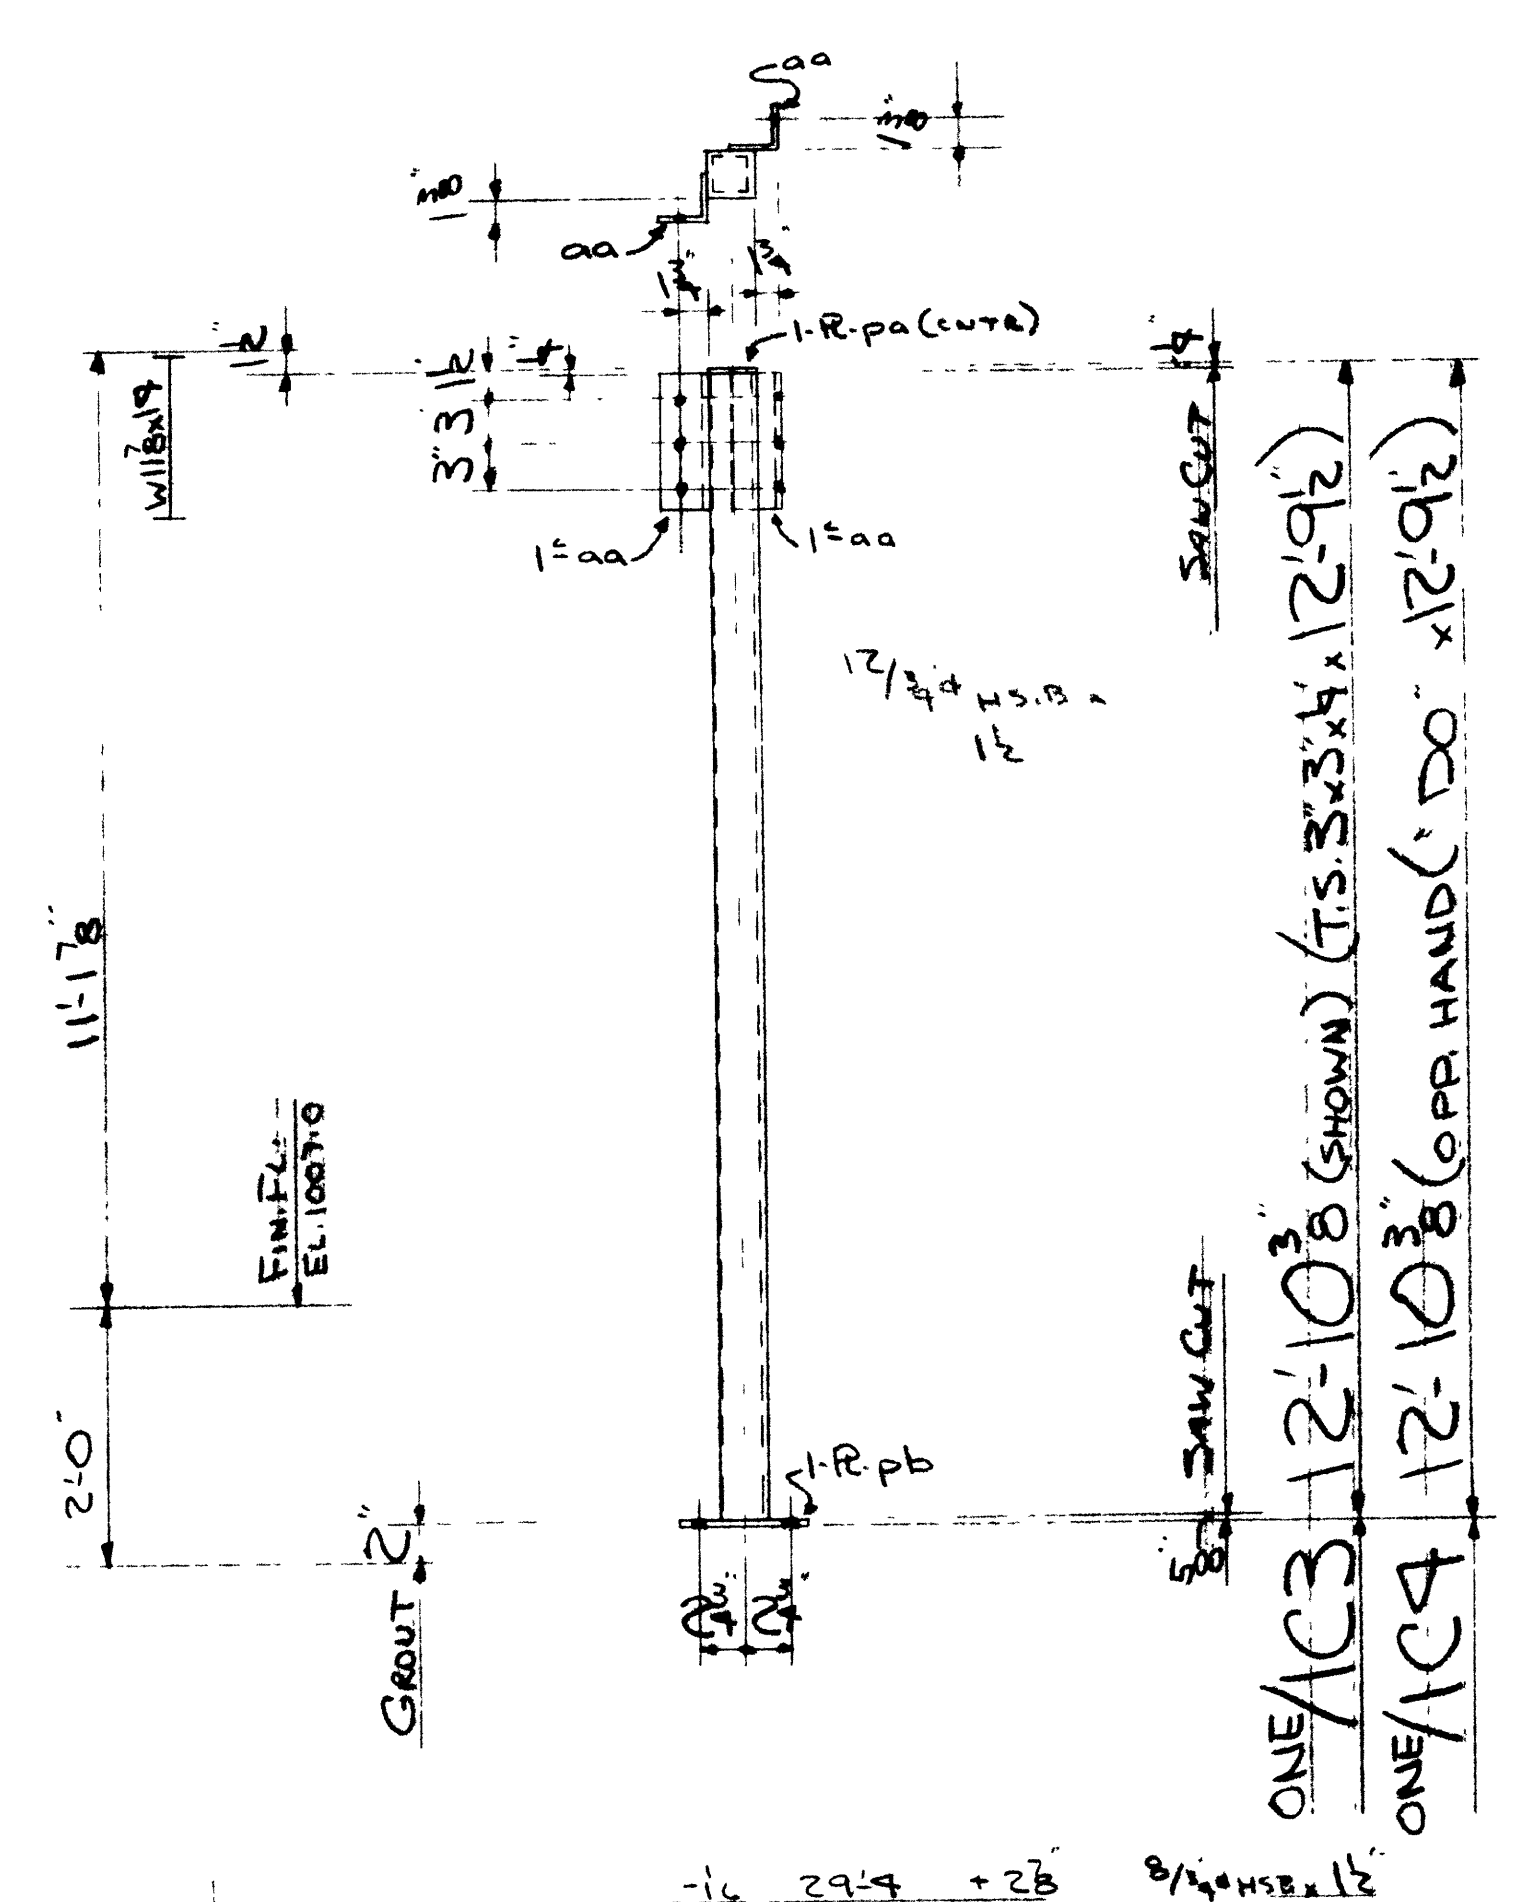
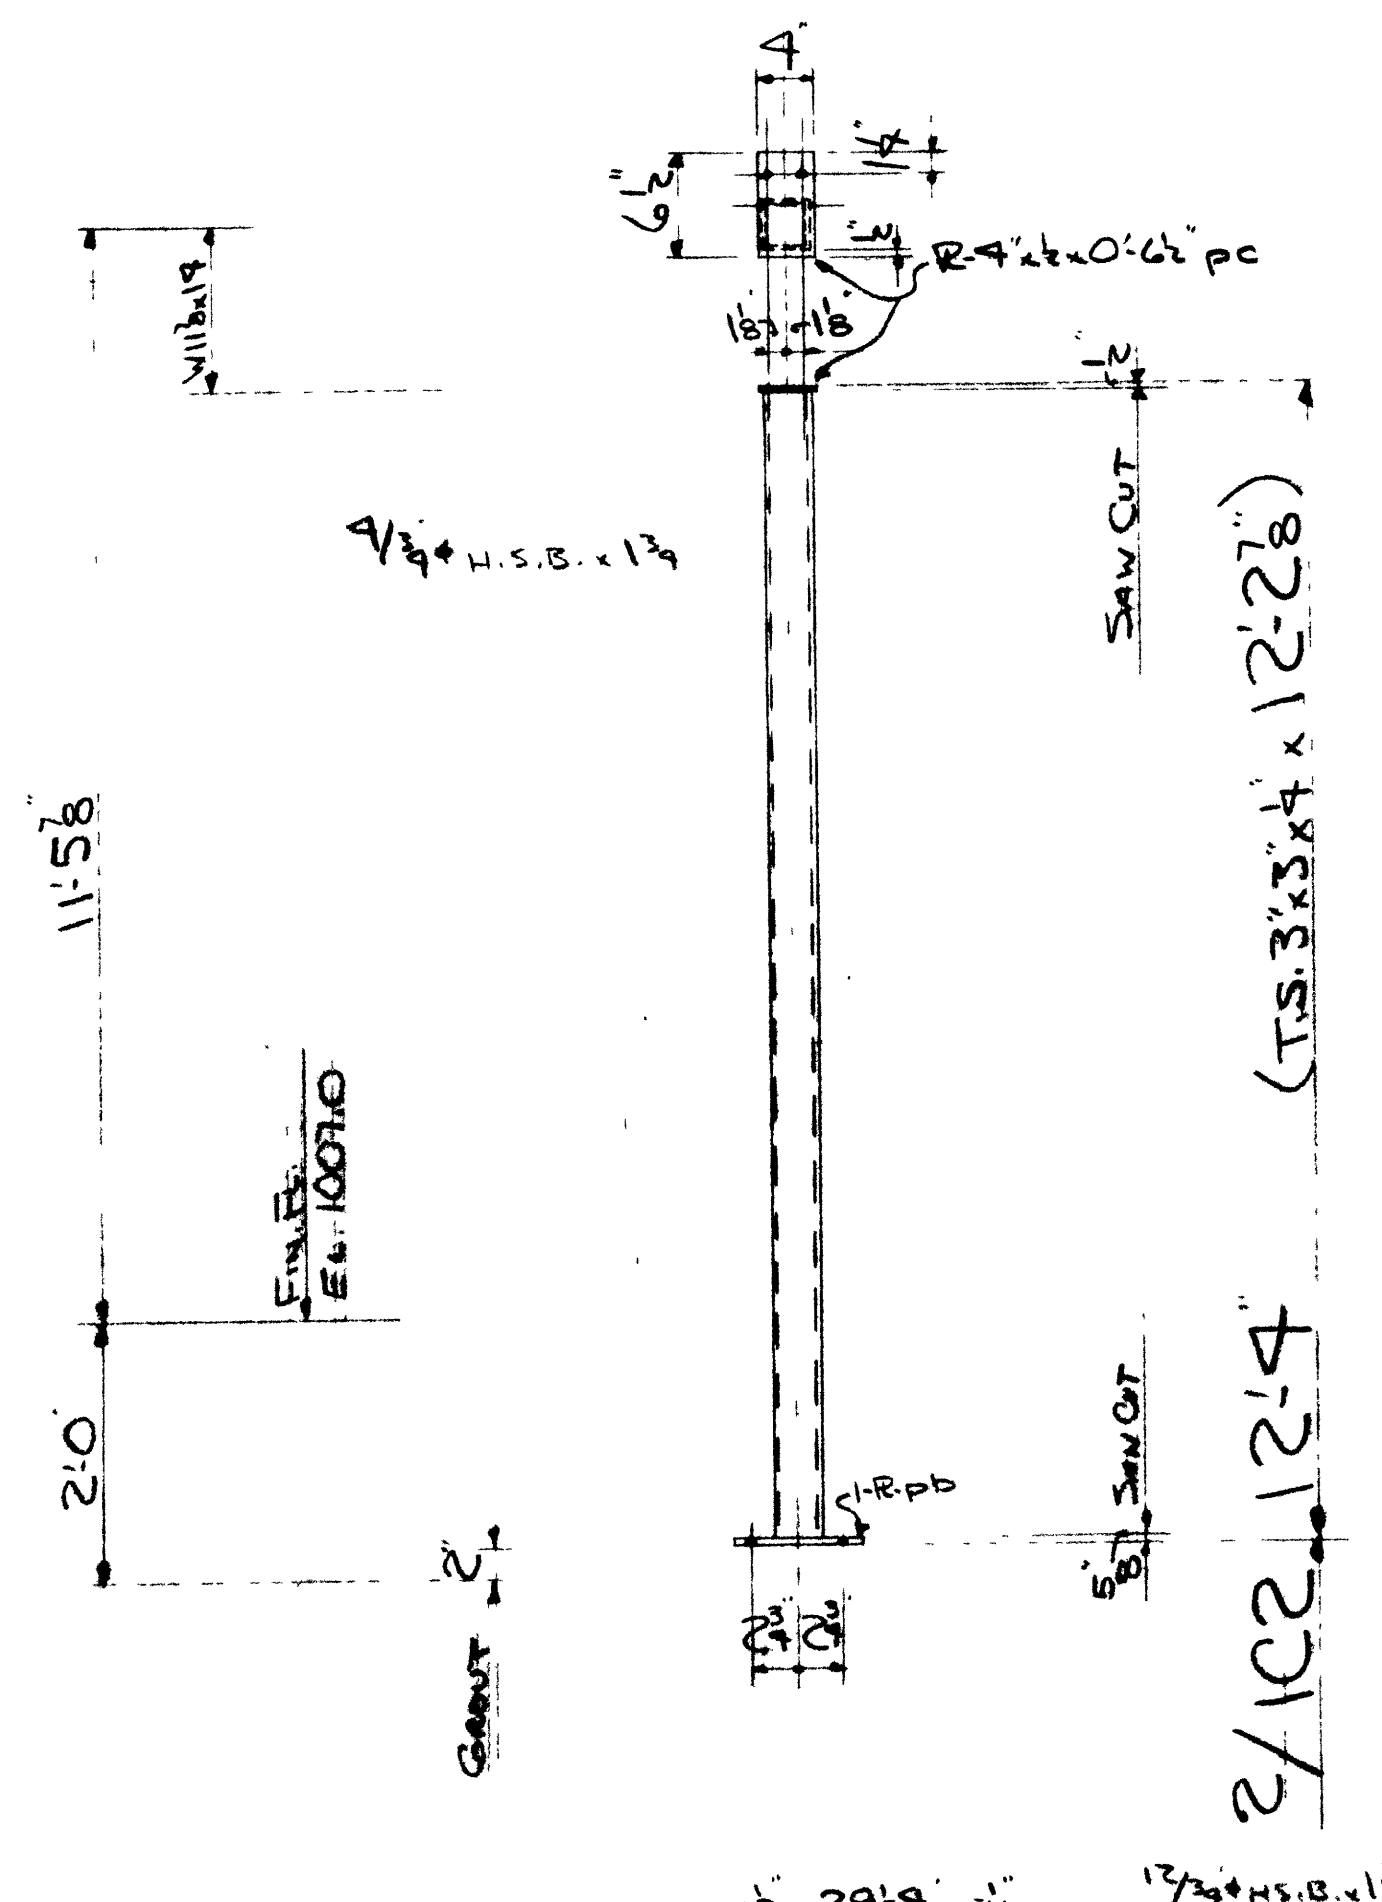


BILL OF MATERIALS

ITEM NO.	PIECES SHIPPED		PIECES FABRICATED					
	NO. PCS.	DATE	MARK	NO. PCS.	SIZE	LENGTH	REMARKS	WEIGHTS
1			IC1	10	T.S. 3x3x4	12'9 1/2"		
2			PA	10	R-3x4	0'3"		
3			PB	10	R-4x5	0'8"		
4			AA	20	3x3x4	0'8 1/2"		
5								
6			IC2	2	T.S. 3x3x4	12'2 1/8"		
7			PB	2				
8			PA	2	R-4x5	0'6 1/2"		
9								
10			IC3	ONE	T.S. 3x3x4	12'9 1/2"		
11			PA	ONE				
12			PB	ONE				
13			PA	2				
14			IC4	ONE	T.S. 3x3x4	12'9 1/2"		
15			PA	ONE				
16			PB	ONE				
17			AA	2				
18								
19			IC5	8	T.S. 3x3x4	11'2 1/8"		
20			PB	8				
21			PA	8	R-4x5	0'9"		
22								
23			IB1	ONE	W12x14	29'3"		
24			AA	2	3x3x4	0'8 1/2"		
25								
26			IB2	ONE	W12x14	29'3"		
27			AA	2				
28								
29			IB3	ONE	W12x14	29'6"		
30			AA	2				
31			AA	2	3x3x4	0'5 1/2"		
32								
33			IB4	ONE	W12x14	29'6"		
34			AA	2				
35			AA	2	3x3x4	0'5 1/2"		
36								
37								
38								
39								
40								
41								
42								
43								
44								
45			IA1	16	3x3x4	0'6"	NO FAB	
46								
47								
48								
49								
50								
51								
52								
53								
54								

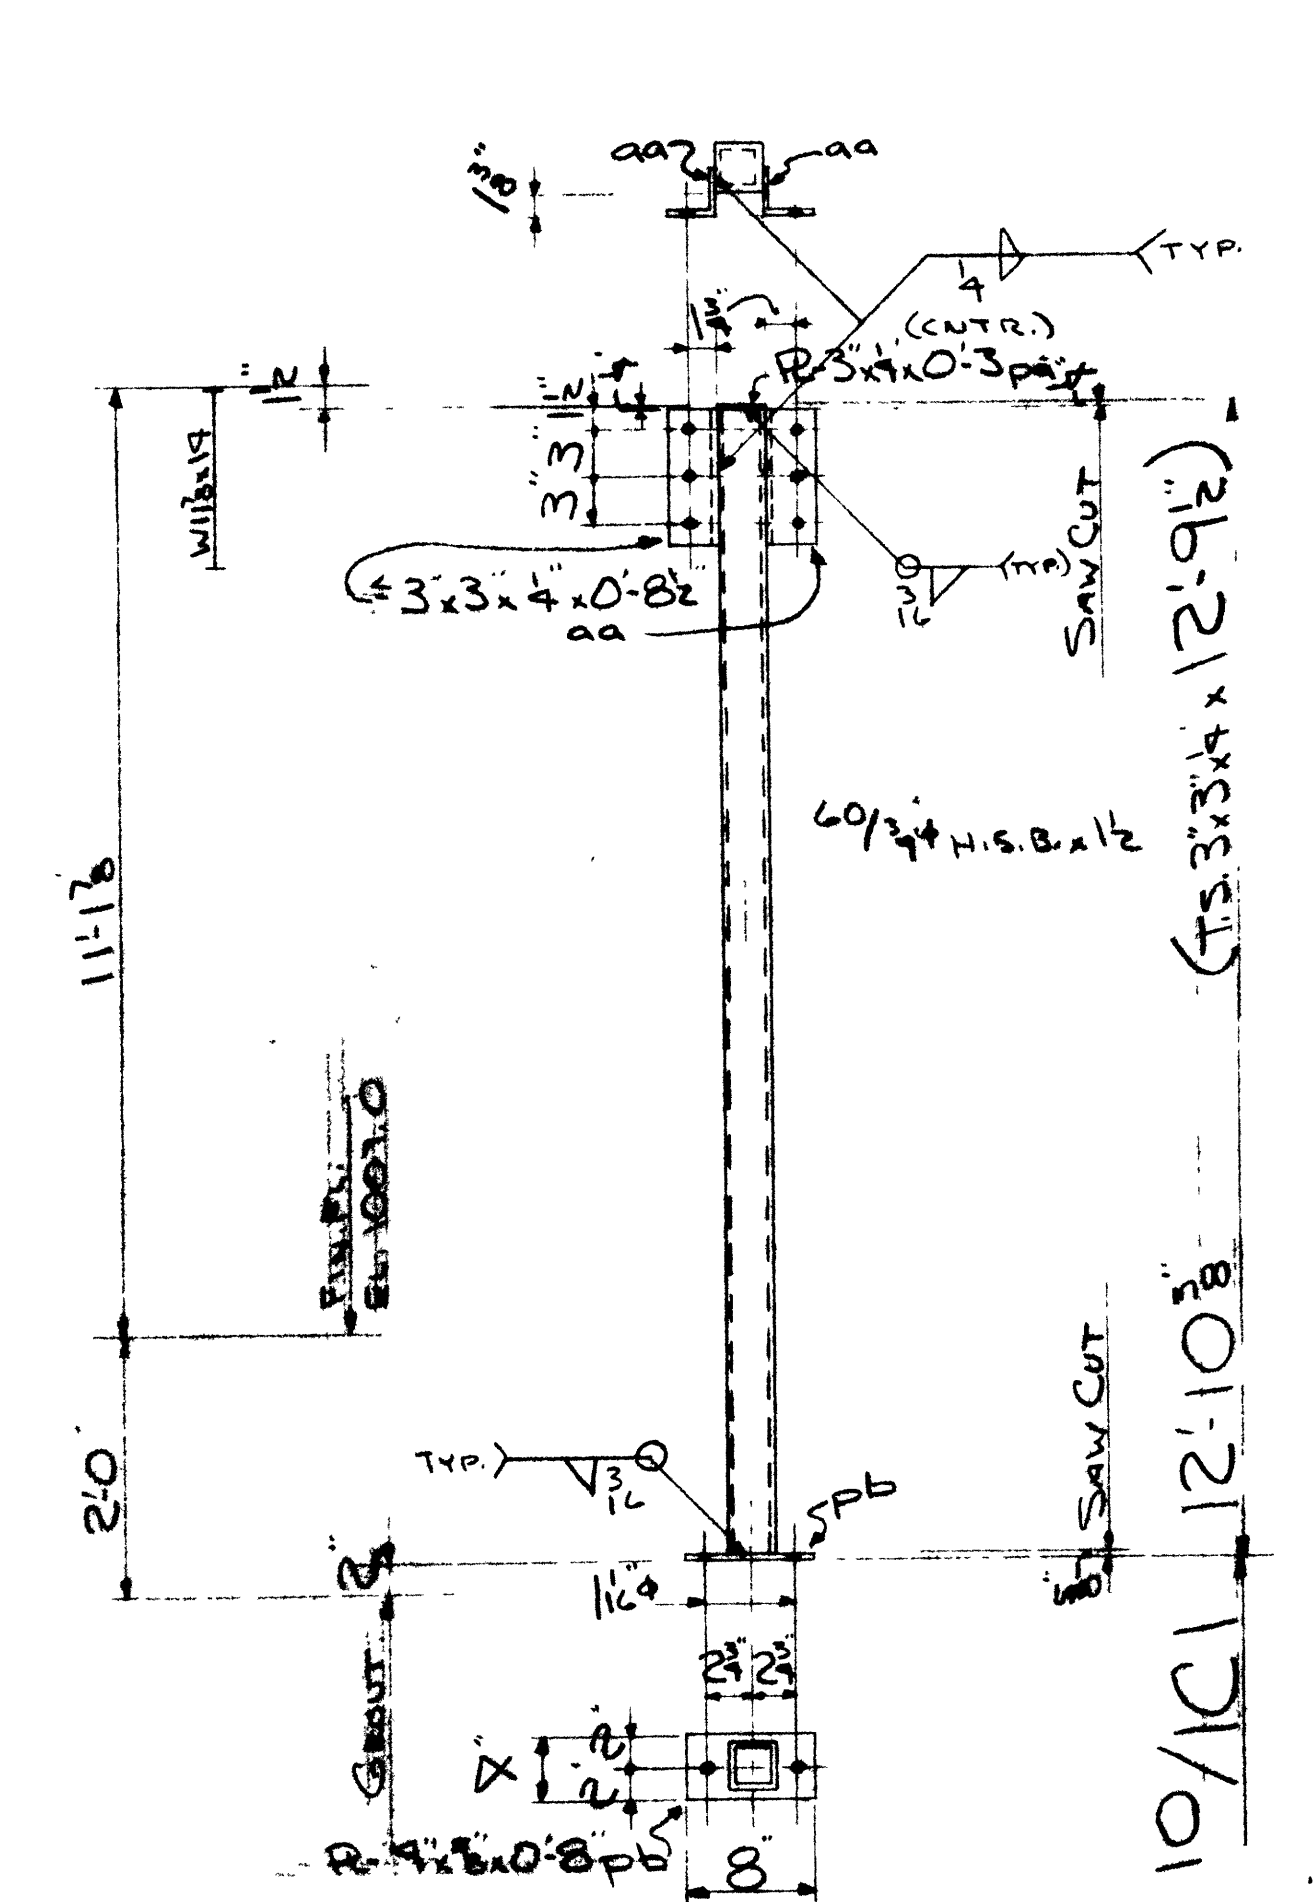

INDICATE SPLICES, IF ANY

RESUBMIT FOR APPROVAL

SECTION A-A

THIS DRAWING IS:  
 APPROVED  
 APPROVED AS NOTED  
 RETURNED FOR CORRECTION  
 RESUBMIT

APPROVAL IS FOR COMPLIANCE WITH CONTRACT DOCUMENTS ONLY. CONTRACTOR IS RESPONSIBLE FOR FABRICATION AND COORDINATION OF THE WORK.  
 BY **BMF** DATE **11-18-75**  
**BOWEN & FEINBERG ASSOCIATES**  
 CONSULTING ENGINEERS

WE ASSUME NO RESPONSIBILITY FOR ERRORS WHEN MATERIAL IS FABRICATED IN ACCORDANCE WITH APPROVED DRAWING.  
 BACKCHARGES WILL NOT BE ACCEPTED UNLESS OUR CONSENT IS GIVEN IN ADVANCE IN WRITING.

**TRACO STEEL INC.**  
 SANDY SPRINGS, S.C. 29677

PROJECT: **ANDREWS JR. HIGH ADDITION**  
 LOCATION: **ANDREWS, N.C.**  
 DWG. COVERS: **COLS. BEAMS**  
 ARCHT. OR ENGR.: **ERIC TOWNSON**  
 CONTRACTOR: **BUNCOMBE CONSTR.**

DATE: \_\_\_\_\_  
 REVISED: **10-20-75**  
 APPROVAL: **7-30-75**  
 FIELD USE: \_\_\_\_\_  
 SHOP: \_\_\_\_\_

SHOP NOTES: \_\_\_\_\_  
 SHOP PAINT: **TT-P-36E**  
 DRAWN BY: **W.S.T.**  
 CHK. BY: \_\_\_\_\_

MOLES U.N. **134**  
 JOB NO. \_\_\_\_\_  
 DRWG. NO. **F-1**